


Revised 4-6-18		CMS#	18199275 HELD PERMIT		
CenturyLink BSW Order/Maintenance Work Authorization					
Company	T600	Exchange Name	MAPLE GROVE	Service Order#	1515707567
Work Activity	Fiber-Buried	Capital	Y	Maintenance	N
Customer Name	CHAD BERGE		Phone#	7634160236	
Address	7361 KIMBERLY LN N		One Call Ticket#		
City & Zip	MAPLE GROVE MN 55311				
Location/Directions					
Description of Work or Special Instructions					
Held Order	Y	Permit:	Y	Bore:	Y
Tech Name and Tech #	DEX		Employee Contact#	651-302-5304	
CBR#	612-817-3083				
Sketch	Material/Labor Units		Footage/Quantity	Comments	
(Include Cntr Line & Pedestal)	Description	Notes			
Cntr Line foot	33	SEB3-22	BSW-3 & plow plcmt		
		SEB3-221	BSW-3 & hand dig plcmt		
Ped#	ONU	SEP	CUTOVER BSW		
Parish/County	Hennep	BM83	BSW guard at house		
		XXSEB-GL	Remove temp drop		
Township:		BM61(1.25)SEB	BSW Bore footage	155	
Section		SEBO PER FT LBR	Fiber & plow plcmt	90	
Range		SEBO PER FT LBR 1	Fiber & hand dig plcmt		
		SEB6-22	BSW-6 & plow plcmt		
		BM2(5/8)(8)	Ground Rod		
		Trip Charge	Trip Charge	1	
		BM61(3)D-Rock CBL	Rock Boring		
		Permit	Permit	1	
Nearest cross st.	73rd pl and lawndale		Plat Page	Map#	

Estimated Cost

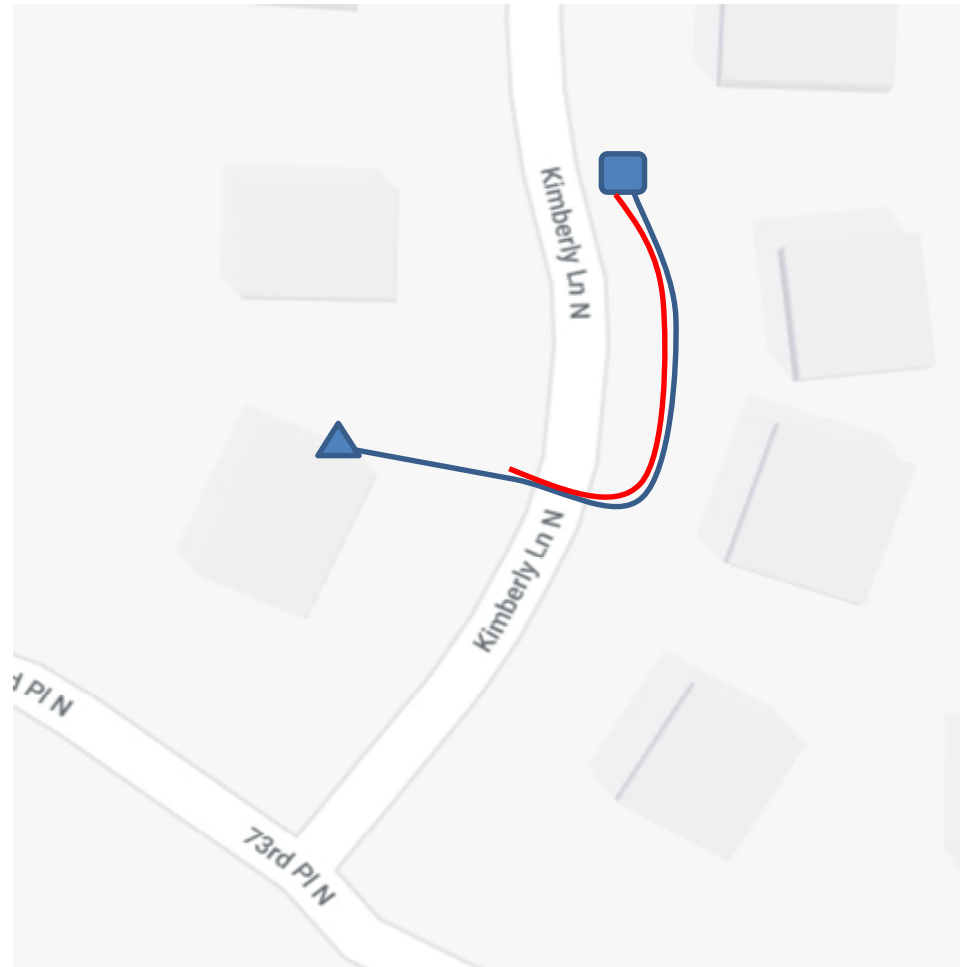

155 FOOT BORE FROM
DOGHOUSE TO
PED 1268-31.1
Red line = bore

Originated By:	Dexter Koepf	Date:	10/17/18	Completed By:		Date:	
Authorized By: (APS)		Date:		Inspected By:		Date:	
Authorized By: (AOM)		Date:					
Email sketch to:	MetroBSW@Centurylink.com						

1. Distance of the bury in Right-of-Way		3. Distance to the nearest intersection	
2. Distance from the terminal to the centerline		4. Nearest State Hwy mile marker	