




Maple Grove  
Xenium Ln N  
Wo 105222074

install 2-30FT dark brz and 2- C LED Cobras by running approx 620FT of #6 Al dx OH and by bore in conduit Approx 700FT of #6 Al dx UG. Terminate Wire

Viewport not mapped

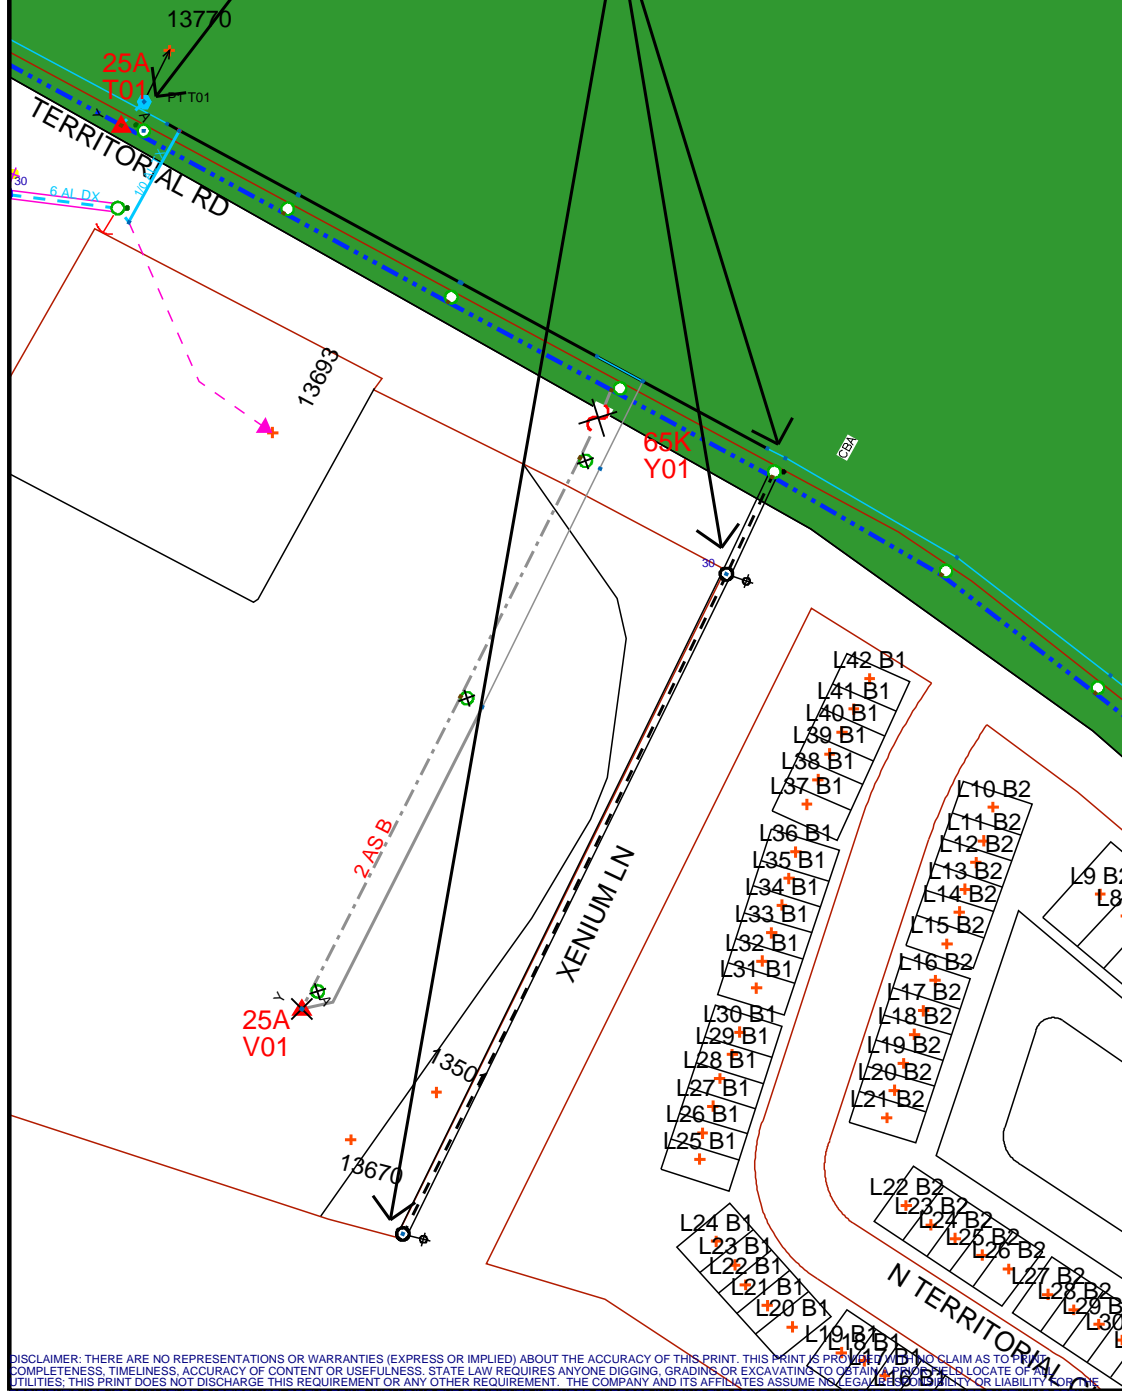

Work Order Information	
Service Request #	:
Design Number	: 00000968346
Designer/Planner ID	: 235012
Designer/Planner Name	: Amedodji, Komla
Designer/Planner Ph #	: (000) 000-0000
Manager Approval	:
Joint Utility	
E:	G:
T:	C:
Design Location	
Division	: Maple Grove
County	: Hennepin
City	: Maple Grove
Address	:
T: 119N	R: 22W S: 3
Map #	: K51096 Permit:
Electric	
Feeder:	Voltage:
Phase:	BkupDevID:
Gas	
System	: Pressure:
Size	: Material :
Dead End:	:
Work Order #	: 000105222074
Date	: 09/22/2020
Sketch: # of # Sketch Data	:
Scale	: 1" equals 167'
 	
CONSTRUCTION USE ONLY	
<input type="checkbox"/>	NO CHANGES (BUILT AS DESIGNED)
<input type="checkbox"/>	CHANGES MADE AS INDICATED (ALL URD MUST HAVE ACTUAL MEASUREMENTS FROM THE FIELD SITE)
RFO	:
FOREMAN	DATE
TEAM LEADER	:

DISCLAIMER: THERE ARE NO REPRESENTATIONS OR WARRANTIES (EXPRESS OR IMPLIED) ABOUT THE ACCURACY OF THIS PRINT. THIS PRINT IS PROVIDED AS IS AND NO CLAIM AS TO THE COMPLETENESS, TIMELINESS, ACCURACY OF CONTENT OR USEFULNESS. STATE LAW REQUIRES ANYONE DIGGING, GRADINGS OR EXCAVATING TO OBTAIN FIELD LOCATES OF ALL UTILITIES. THIS PRINT DOES NOT DISCHARGE THIS REQUIREMENT OR ANY OTHER REQUIREMENT. THE COMPANY AND ITS AFFILIATES ASSUME NO LEGAL LIABILITY OR LIABILITY FOR THE RECIPIENT'S USE OR ANY OTHER PARTIES' USE OF THE PRINT, INCLUDING THE RECIPIENT'S INTENDED PURPOSE IN USING THE PRINT. NO COMPANY EMPLOYEE OR OTHER PARTY HAS BEEN AUTHORIZED TO PROVIDE THIS PRINT FOR PLANNING OR ESTIMATING PURPOSES. RELY ON THIS PRINT AT YOUR OWN RISK. BY ACCEPTING THIS PRINT, THE RECIPIENT & ANY OTHER PARTY RECEIVING A COPY OF THE PRINT ACKNOWLEDGES AND AGREES TO THIS DISCLAIMER. For All Field Locates Call 811

THIS DOCUMENT IS XCEL ENERGY CONFIDENTIALS AND PROPRIETARY INFORMATION AND MAY NOT BE REPRODUCED IN WHOLE, OR IN PART, NOR MAY ANY OF THE INFORMATION CONTAINED HEREIN BE DISCLOSED WITHOUT THE CONSENT OF XCEL ENERGY. CONFIDENTIALS AND PROPRIETARY INFORMATION © 2019 XCEL ENERGY INC. | XCEL ENERGY IS REGISTERED TRADEMARK OF XCEL ENERGY INC