


ASBUILT

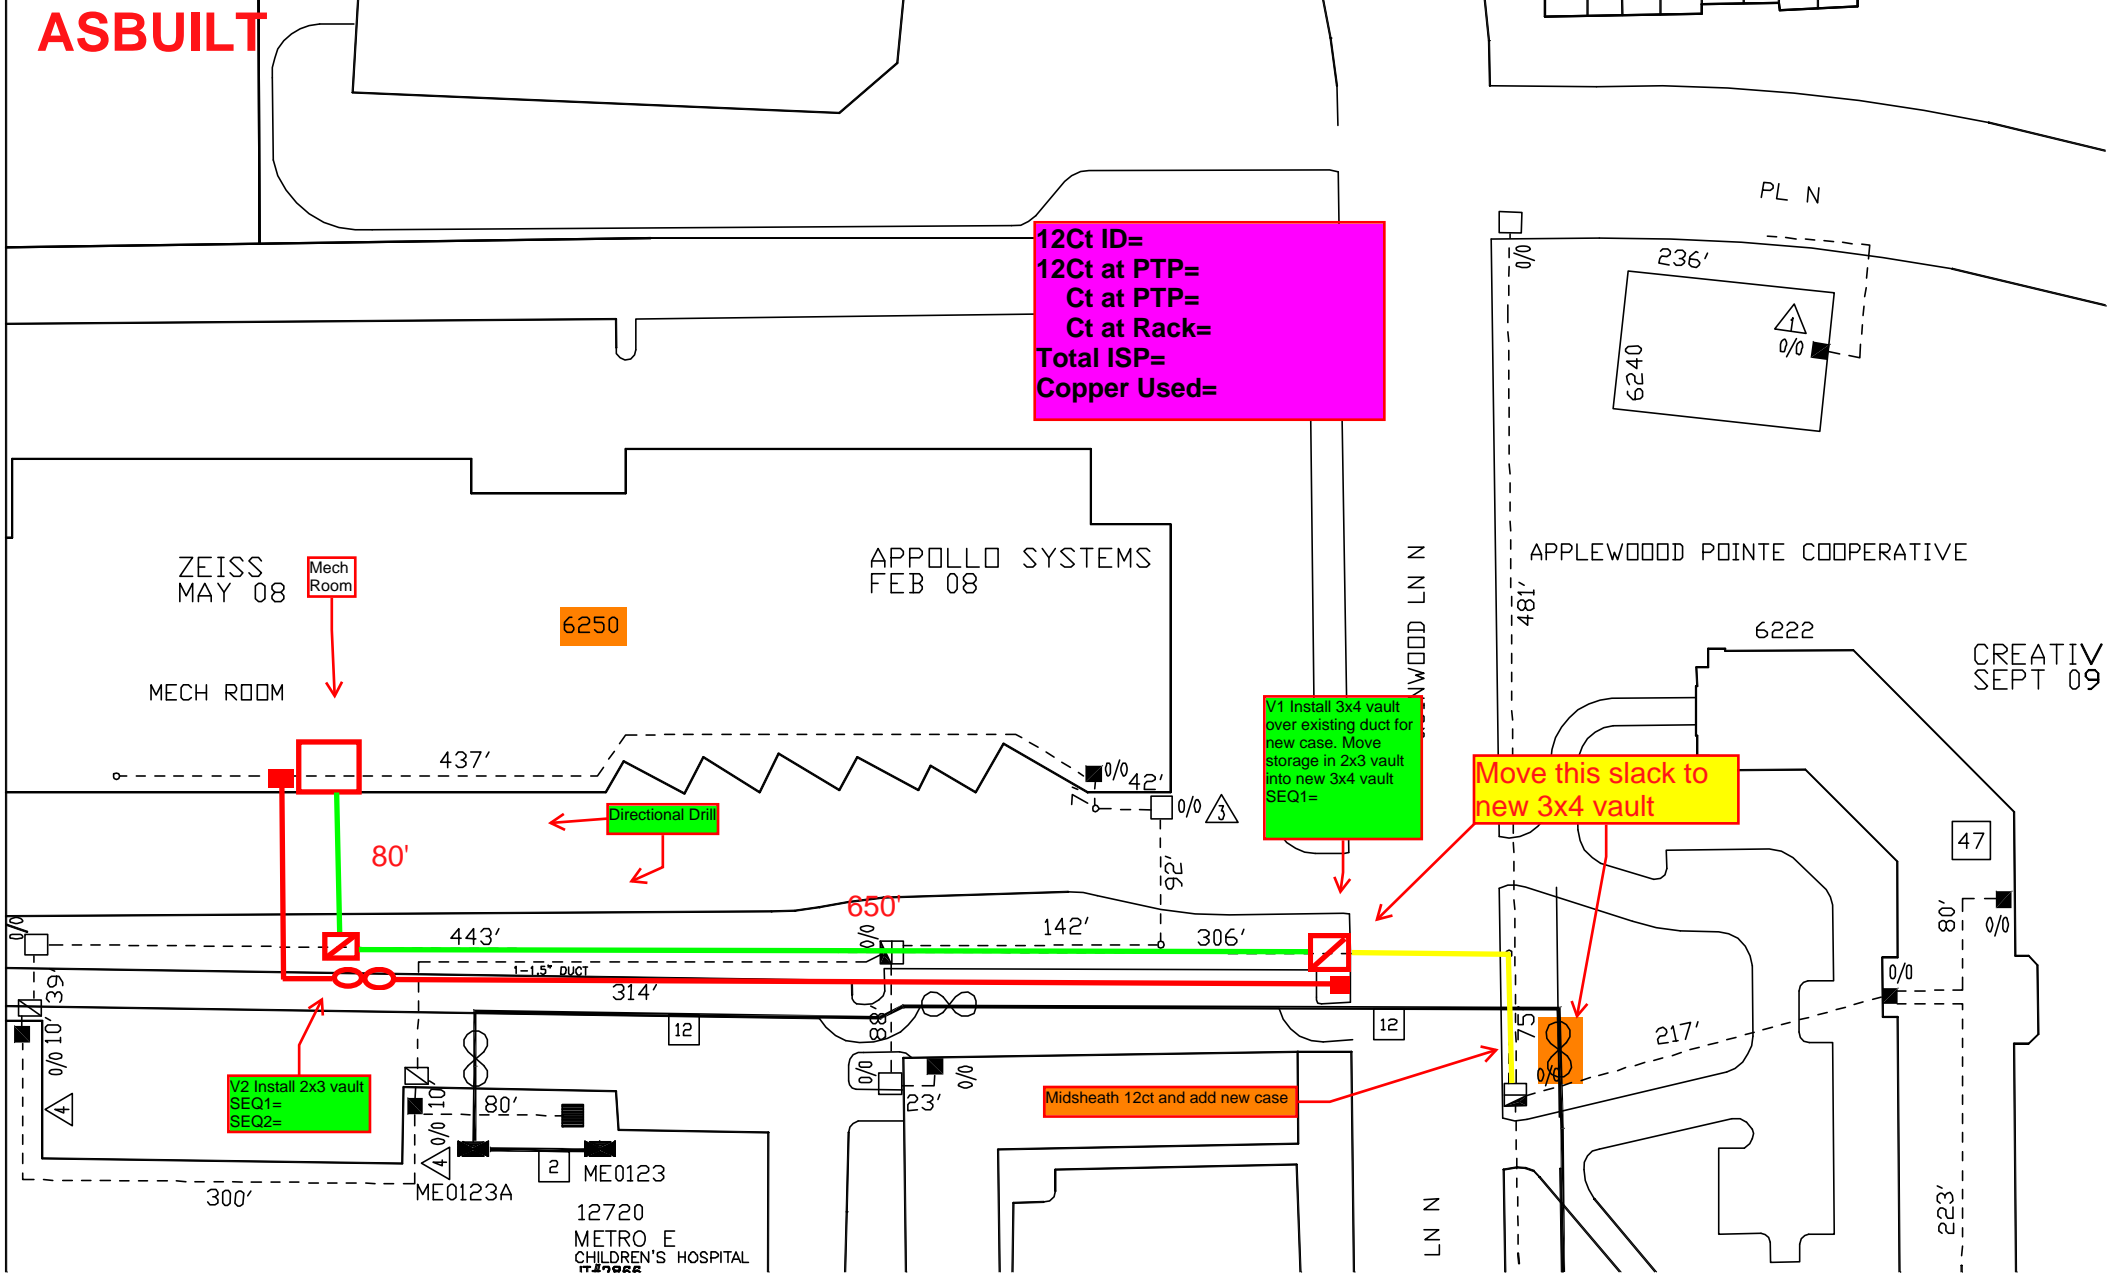

12Ct ID=
 12Ct at PTP=
 Ct at PTP=
 Ct at Rack=
 Total ISP=
 Copper Used=

V1 Install 3x4 vault
 over existing duct for
 new case. Move
 storage in 2x3 vault
 into new 3x4 vault
 SEQ1=

Move this slack to
 new 3x4 vault

V2 Install 2x3 vault
 SEQ1=
 SEQ2=

Midsheath 12ct and add new case

New UG=
 Duct Size=

Vaults Set=