
ASBUILT



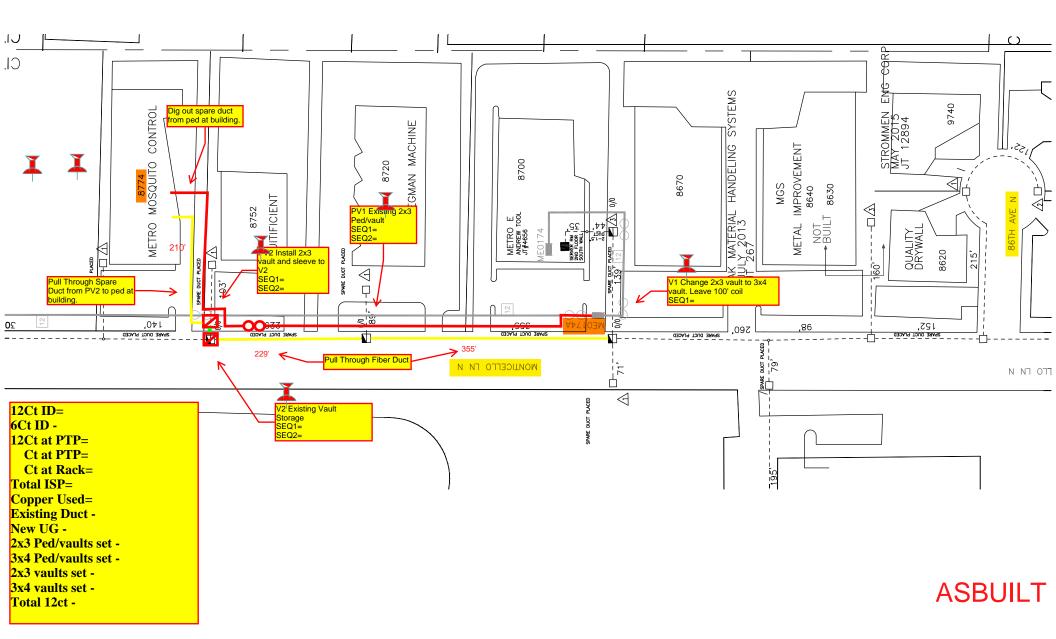

ME 022143 - Metro Mosquito Control - 8774 Monticello LN N - Maple Grove